




A1

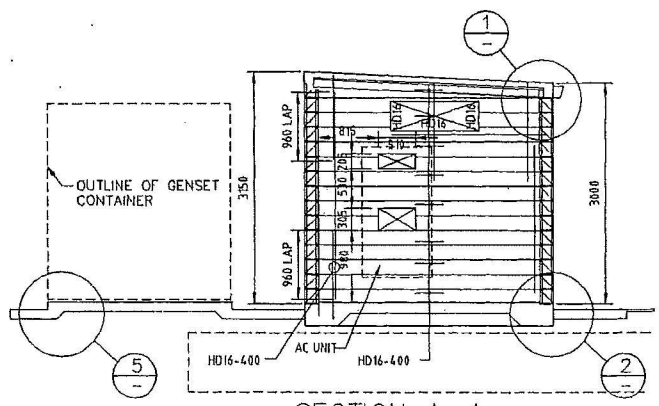


SECTION A-A
1:50

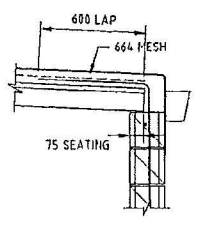


DETAIL 1
1:20

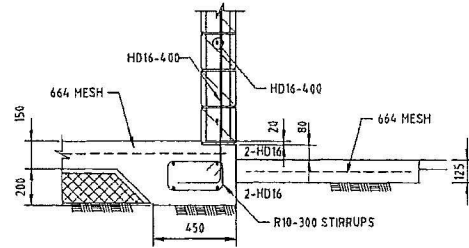


DETAIL 2
1:20

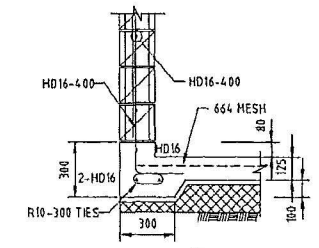


DETAIL 3
1:20

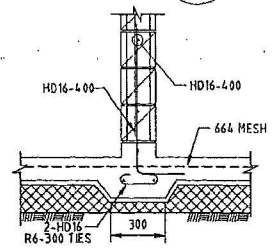


DETAIL 4
1:20

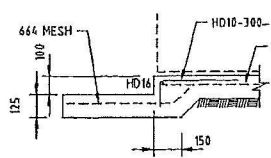


DETAIL 5
1:20

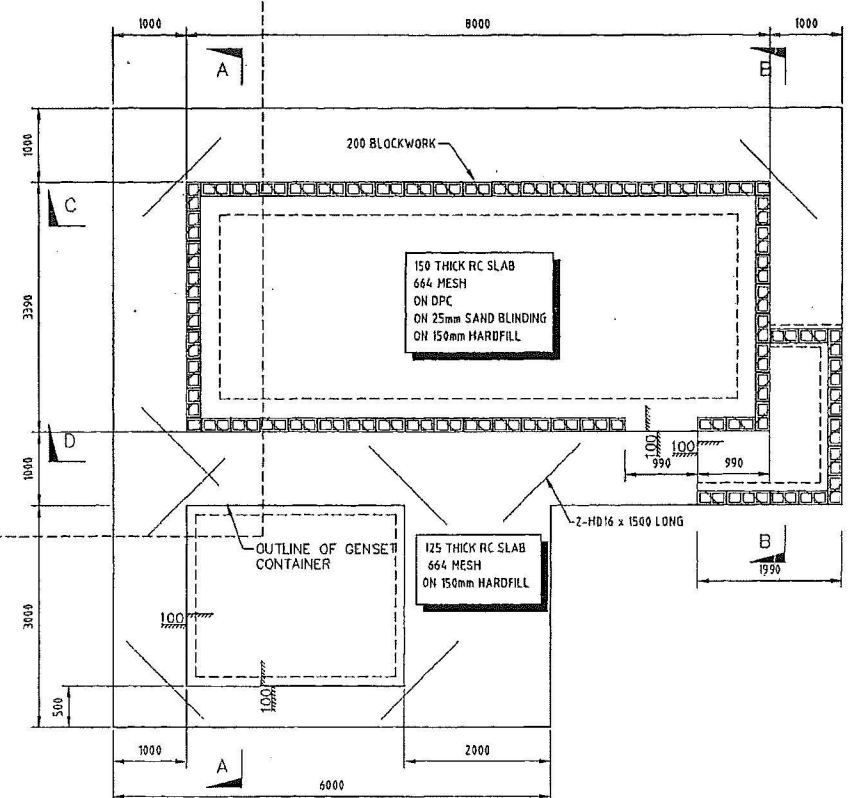


FOUNDATION AND SLAB PLAN

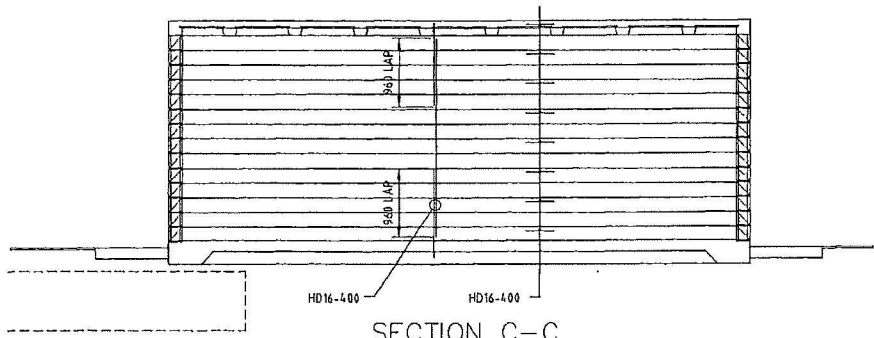


SECTION C-C
1:50

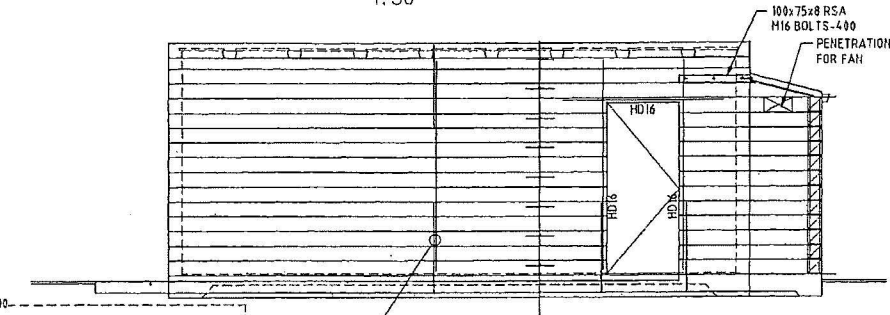


SECTION D-D
1:50

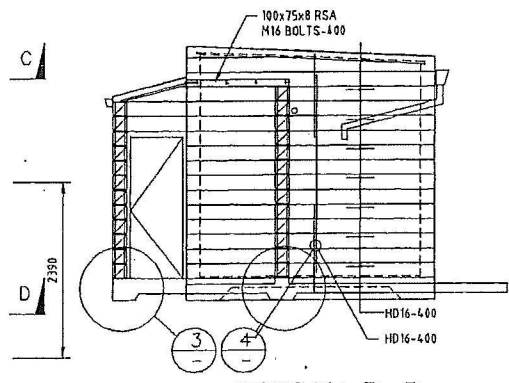


SECTION B-B
1:50

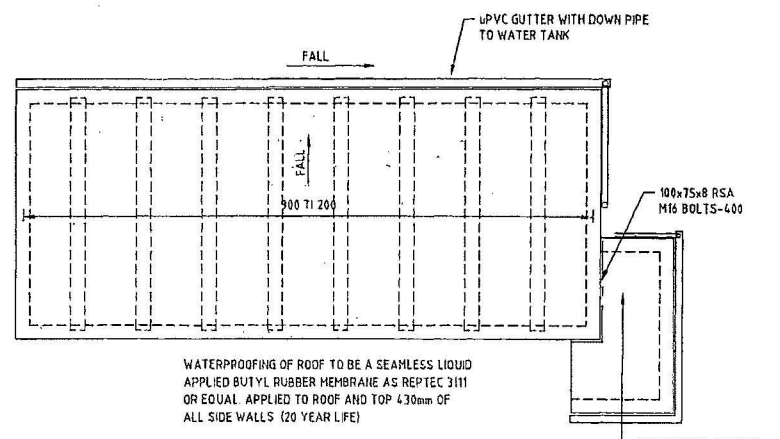


ROOF PLAN

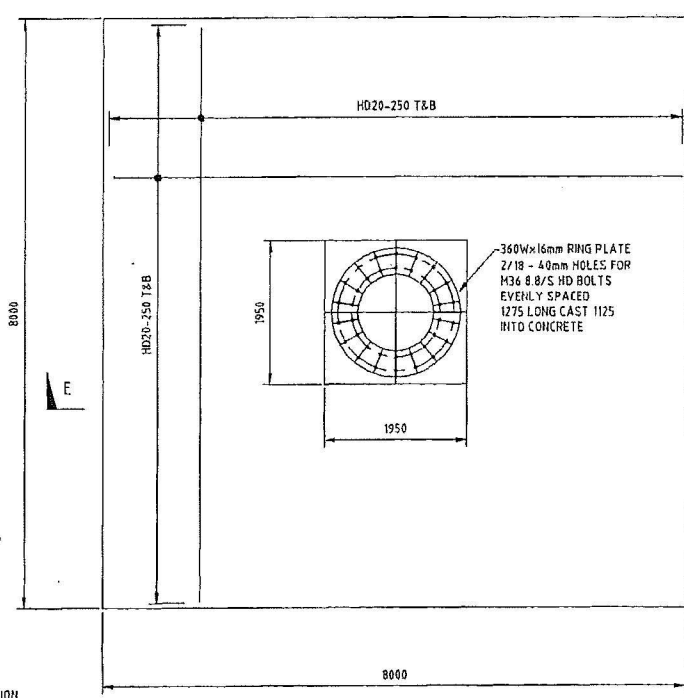

MONOPOLE FOUNDATION PAD
1:50

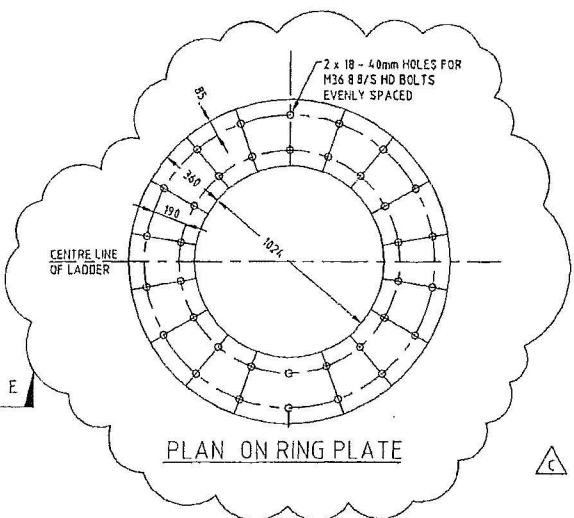

PLAN ON RING PLATE

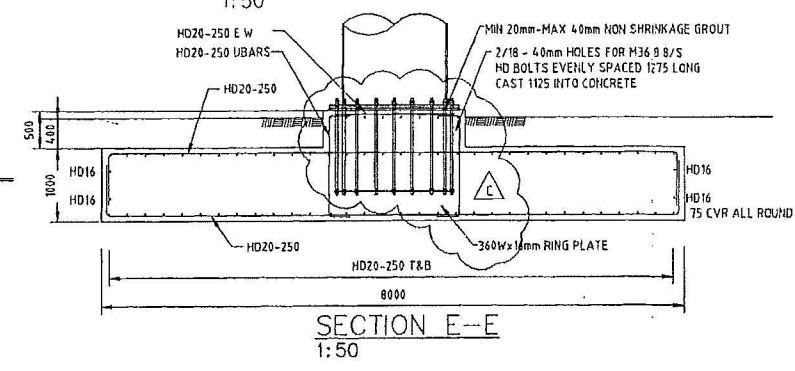

SECTION E-E
1:50

Rev.	Date	Revision Details	By	Ver.	App.
C	23.05.01	REVISED BASE PLATE	JH		
B	23.05.01	LADDER CENTRE LINE ADDED	DH		
A	27.03.01	CONSTRUCTION ISSUE	ARC		
O2	20.12.00	TENDER ISSUE	JL		
O1	20.10.00	FOR PRICING	AD		

Connell Wagner
 Connell Wagner Limited Auckland Office
 PO Box 9762, Newmarket, Auckland
 Tel: +64 9 524-8019
 Fax: +64 9 524-7815
 Email: alicad@connwag.com

Client: **BCL**

Project: **BCL KAIPARA HILLS LINK SITE RODNEY DISTRICT**

Drawn	Signed	Date

Draying Title: **PROPOSED EQUIPMENT SHELTER AND SLAB LAYOUT**

AS BUILT
 CW Project No. **4905**
 Scale: **1:50 1:20**
 Drawing No. **4905S01** Rev. **C**

KORDIA 18039-68