


**LEGEND:**

	WAP AS-BUILT ALIGNMENT
	WAP AS-BUILT SURVEY POINTS
	WAP ALIGNMENT AS SHOWN ON LEGAL EASEMENT PLANS
	LEGAL PROPERTY BOUNDARY
	12m EASEMENT AS PER DEPOSITED PLANS
	12m DESIGNATION
	6m DESIGNATION
	POWER 11kV
	POWER LOW VOLTAGE
	COMMUNICATIONS CABLE
	GAS
	WATER SUPPLY
	STORMWATER
	SANITARY SEWER
	A.I.A.L. OWNED LAND

**NOTES:**

1. UNDERGROUND SERVICES SHOWN WITHIN 25m OF WAP ONLY.
2. WHERE 12m DESIGNATION BOUNDARY IS SHOWN DIRECTLY ALONG SIDE 12m EASEMENT BOUNDARY THE TWO SHALL BE CONSIDERED COINCIDENT.
3. WHERE 6m DESIGNATION BOUNDARY IS SHOWN DIRECTLY ALONG SIDE PROPERTY BOUNDARY THE TWO SHALL BE CONSIDERED COINCIDENT.
4. NO A.I.A.L. OWNED LAND ON THIS SHEET.

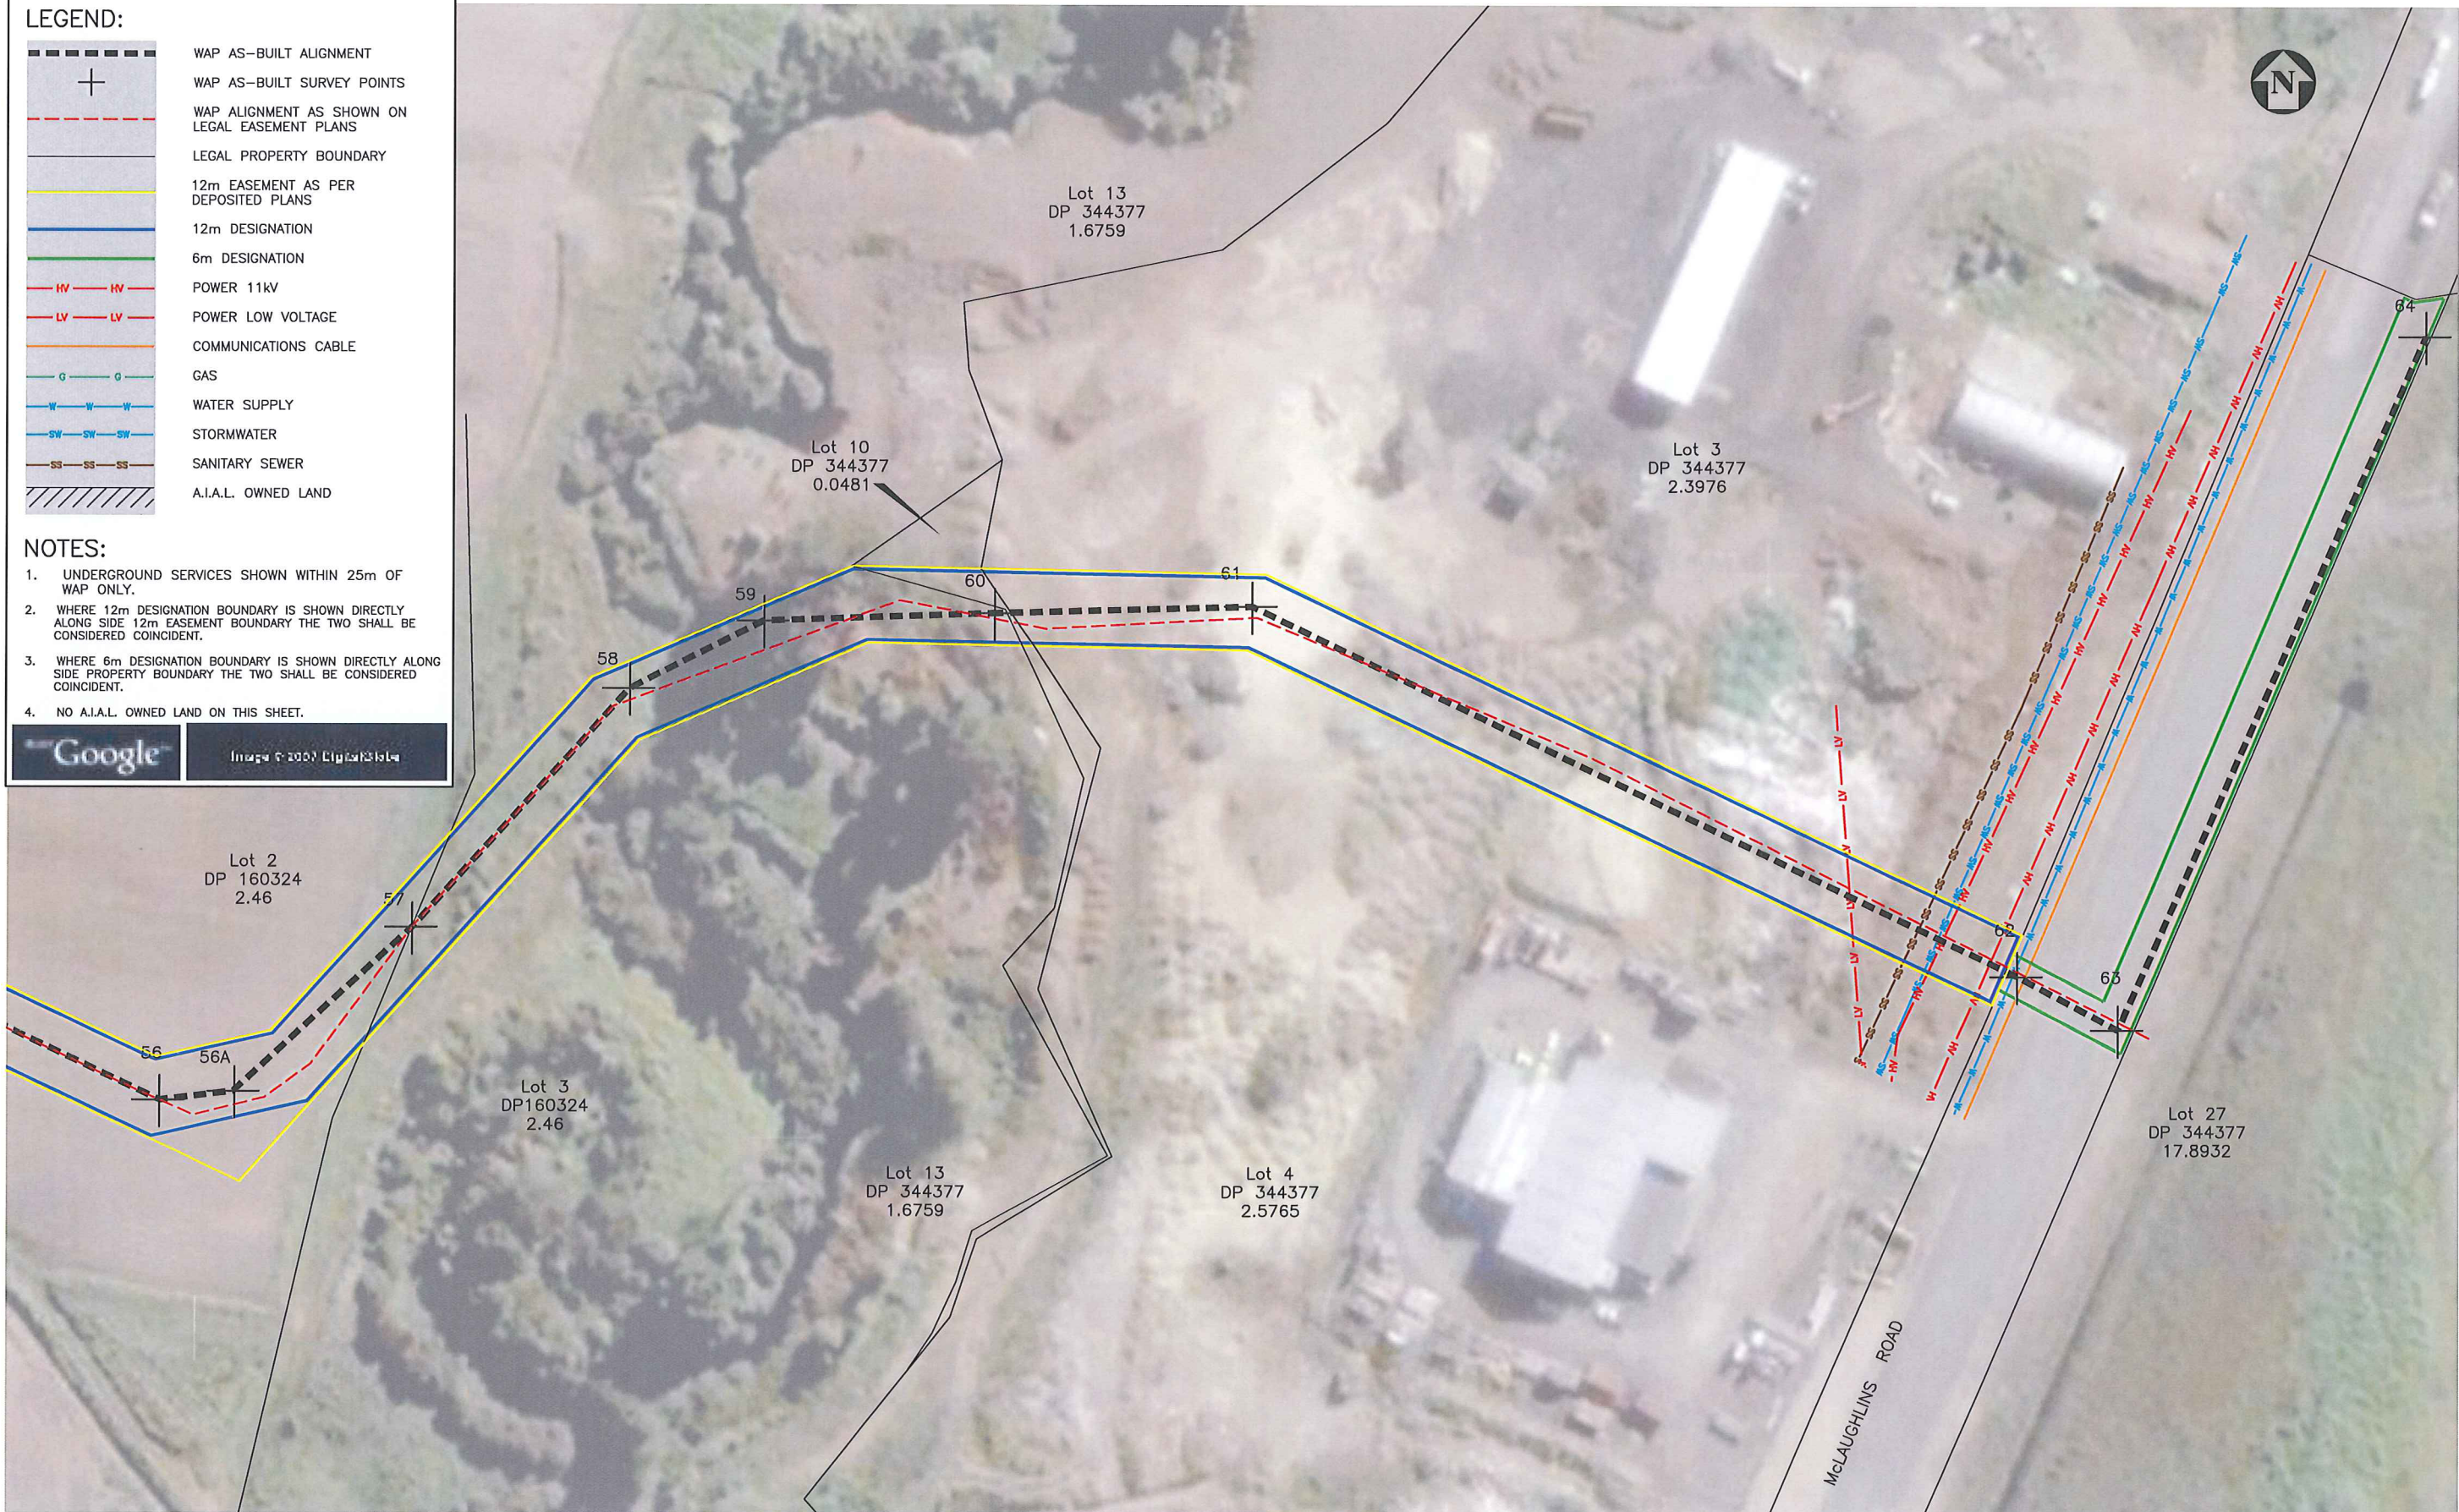

IMAGES FROM GOOGLE EARTH

**PRIVATE AND CONFIDENTIAL**

Rev	Revision Description	Designed	Drawn	Checked	Approved	Date
E	6m and 12m DESIGNATIONS ADDED		AJP			12NOV09
D	REVISED FINAL ISSUE		AJP		RF	26OCT07
C	FINAL ISSUE		AJP	KS	RF	07AUG07
B	SCALE AMENDED -- SHEETS ADDED		AJP			25JUL07
A	DRAFT		AJP			29MAY07



URS New Zealand Limited  
 Level 6, URS Centre  
 13-15 College Hill, Auckland  
 Phone: 9-355 1300  
 Fax: 9-355 1333

WIRI OIL SERVICES LIMITED

WIRI TO AIRPORT PIPELINE

WAP ROUTE  
 (SUBJECT TO FINAL VERIFICATION)

Status	FINAL
Drawing Number	C-001
Revision	E